


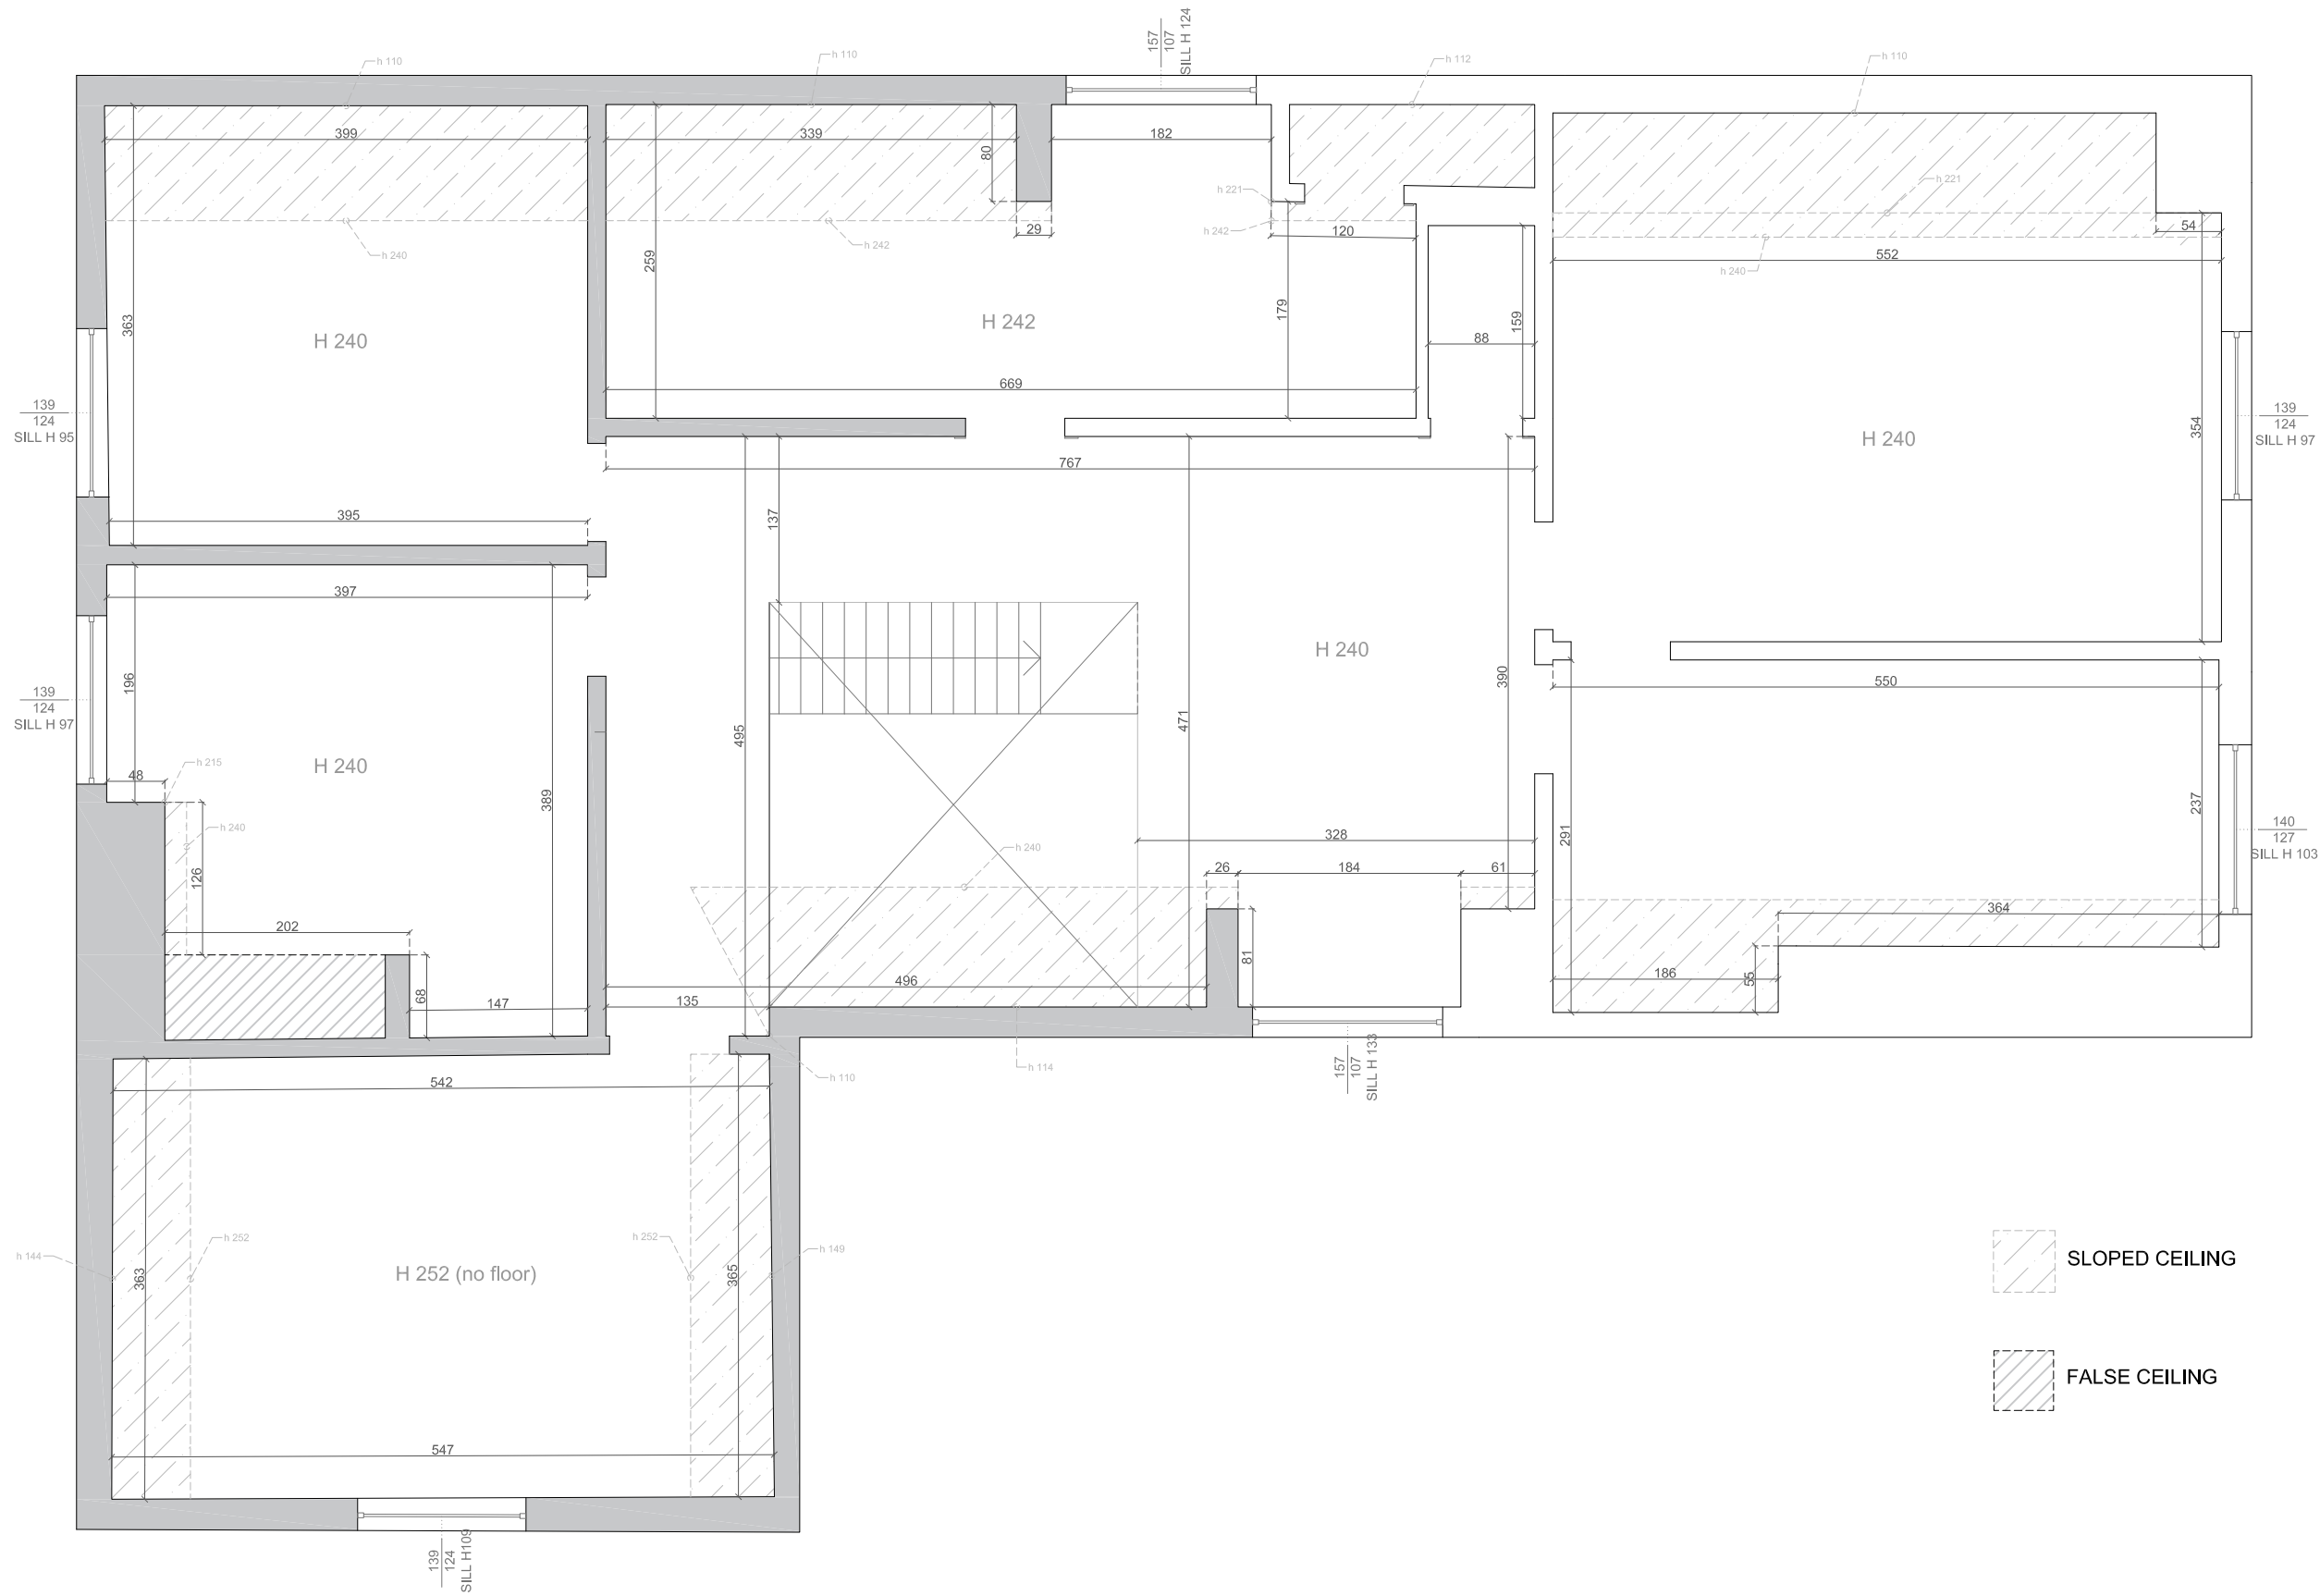

	PROJECT	ID_013	Tutte le misure sono da considerarsi indicative e possono essere soggette a cambiamenti, a nostro insindacabile giudizio, in base alle normali esigenze della produzione artigianale. All measurements are for guidance only and they may be subject to change, in our sole discretion, according to the normal needs of the artisanal production. Все размеры являются ориентировочными и могут быть подвергнуты изменениям на усмотрение фабрики, в соответствии с потребностями ремесленного производства.	TAV.	REV.	DATA	MODENESE GASTONE INTERIORS SRL Via Roma, 106/92 - 35040, Casale di Scodista (PD) ITALY Tel.: +39 0429 879146 E-mail: info@modeneseinteriors.com Web site: www.modeneseinteriors.com PROJECT OFFICER SIGN FOR APPROVAL	LUDOVICA INFANTI
	DESCRIPTION	FIRST FLOOR - AS BUILT		1	0	14/06/2024		