


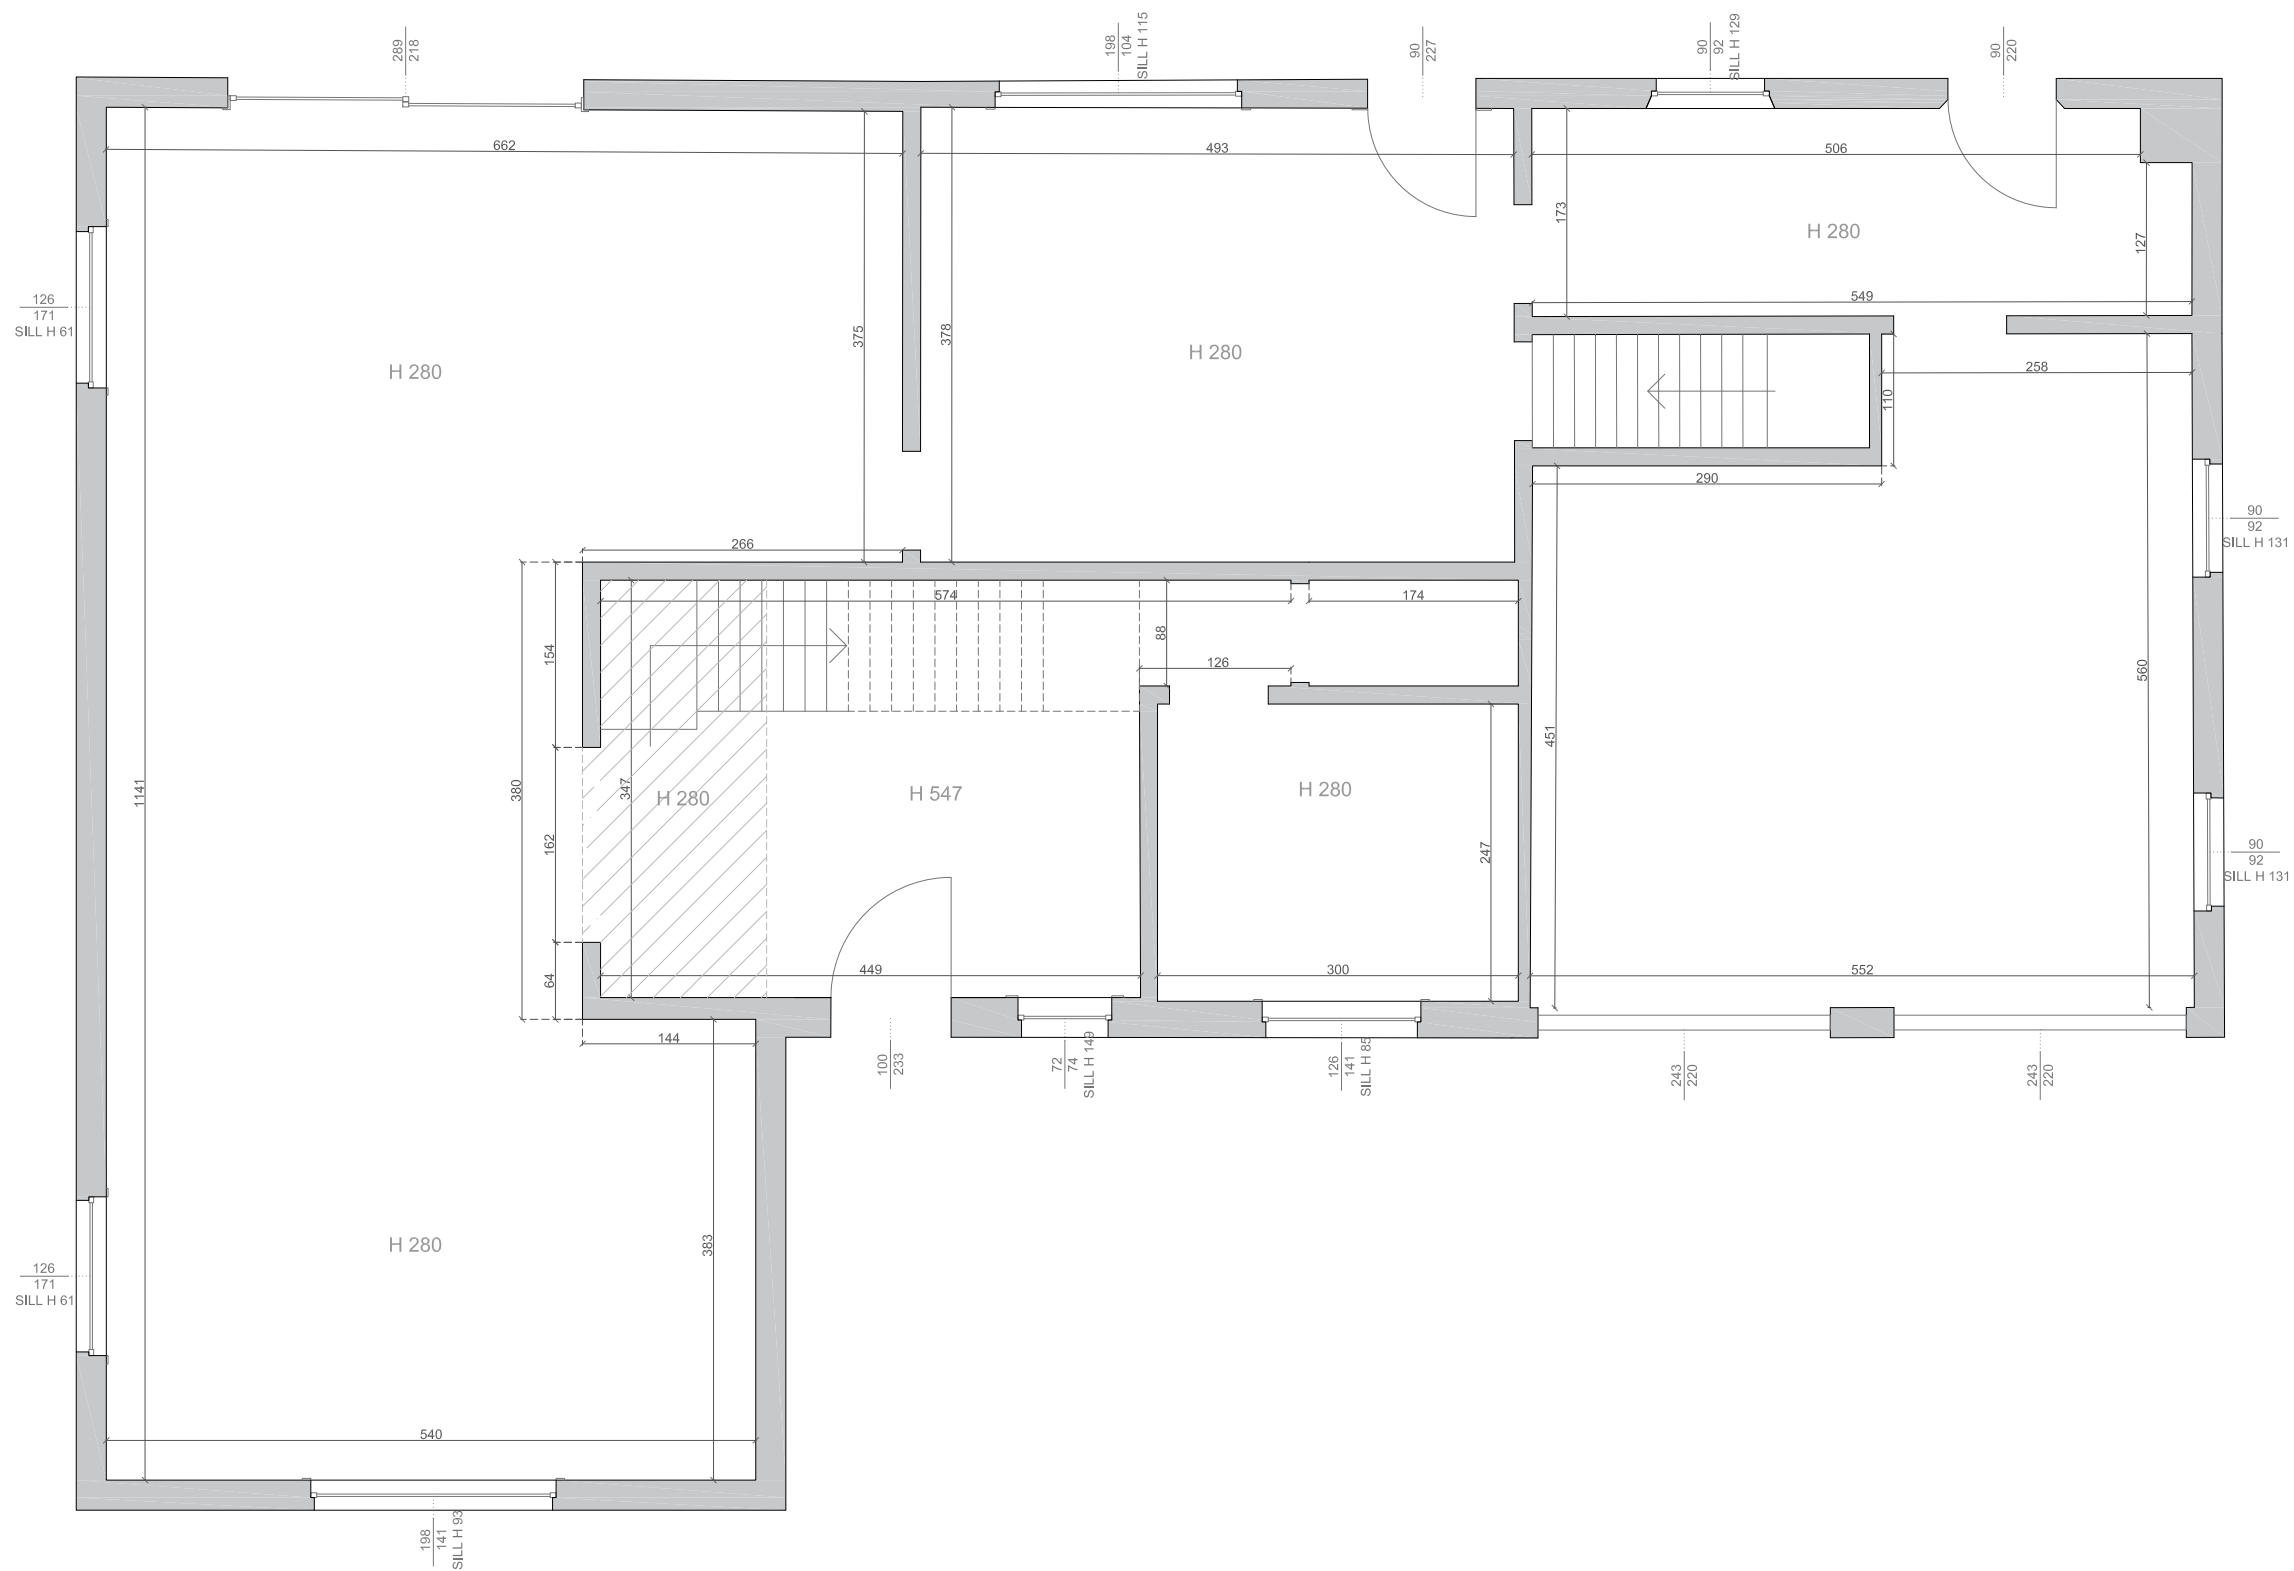

|                                                                                    |             |                         |                                                                                                                                                                                                                                                                                                                                                                                                                                                                                                                                    |      |      |            |                                                                                                                                                                                                                                                                                                                                                                                                  |
|------------------------------------------------------------------------------------|-------------|-------------------------|------------------------------------------------------------------------------------------------------------------------------------------------------------------------------------------------------------------------------------------------------------------------------------------------------------------------------------------------------------------------------------------------------------------------------------------------------------------------------------------------------------------------------------|------|------|------------|--------------------------------------------------------------------------------------------------------------------------------------------------------------------------------------------------------------------------------------------------------------------------------------------------------------------------------------------------------------------------------------------------|
|  | PROJECT     | ID_013                  | <p>Tutte le misure sono da considerarsi indicative e possono essere soggette a cambiamenti, a nostro insindacabile giudizio, in base alle normali esigenze della produzione artigianale.</p> <p>All measurements are for guidance only and they may be subject to change, in our sole discretion, according to the normal needs of the artisanal production.</p> <p>Все размеры являются ориентировочными и могут быть подвергнуты изменениям на усмотрение фабрики, в соответствии с потребностями ремесленного производства.</p> | TAV. | REV. | DATA       |  <div>MODENESE GASTONE INTERIORS SRL</div> <div>Via Roma, 106/92 - 35040, Casale di Scodosia (PD) ITALY Tel.: +39 0429 879146</div> <div>E-mail: info@modeneseinteriors.com Web site: www.modeneseinteriors.com</div>  |
|                                                                                    | DESCRIPTION | GROUND FLOOR - AS BUILT |                                                                                                                                                                                                                                                                                                                                                                                                                                                                                                                                    | 1    | 0    | 14/06/2024 |                                                                                                                                                                                                                                                                                                                                                                                                  |
|                                                                                    |             |                         |                                                                                                                                                                                                                                                                                                                                                                                                                                                                                                                                    |      |      |            |                                                                                                                                                                                                                                                                                                                                                                                                  |
|                                                                                    |             |                         |                                                                                                                                                                                                                                                                                                                                                                                                                                                                                                                                    |      |      |            |                                                                                                                                                                                                                                                                                                                                                                                                  |